


COLOR SCHEME: "ATLANTIS BLUE"

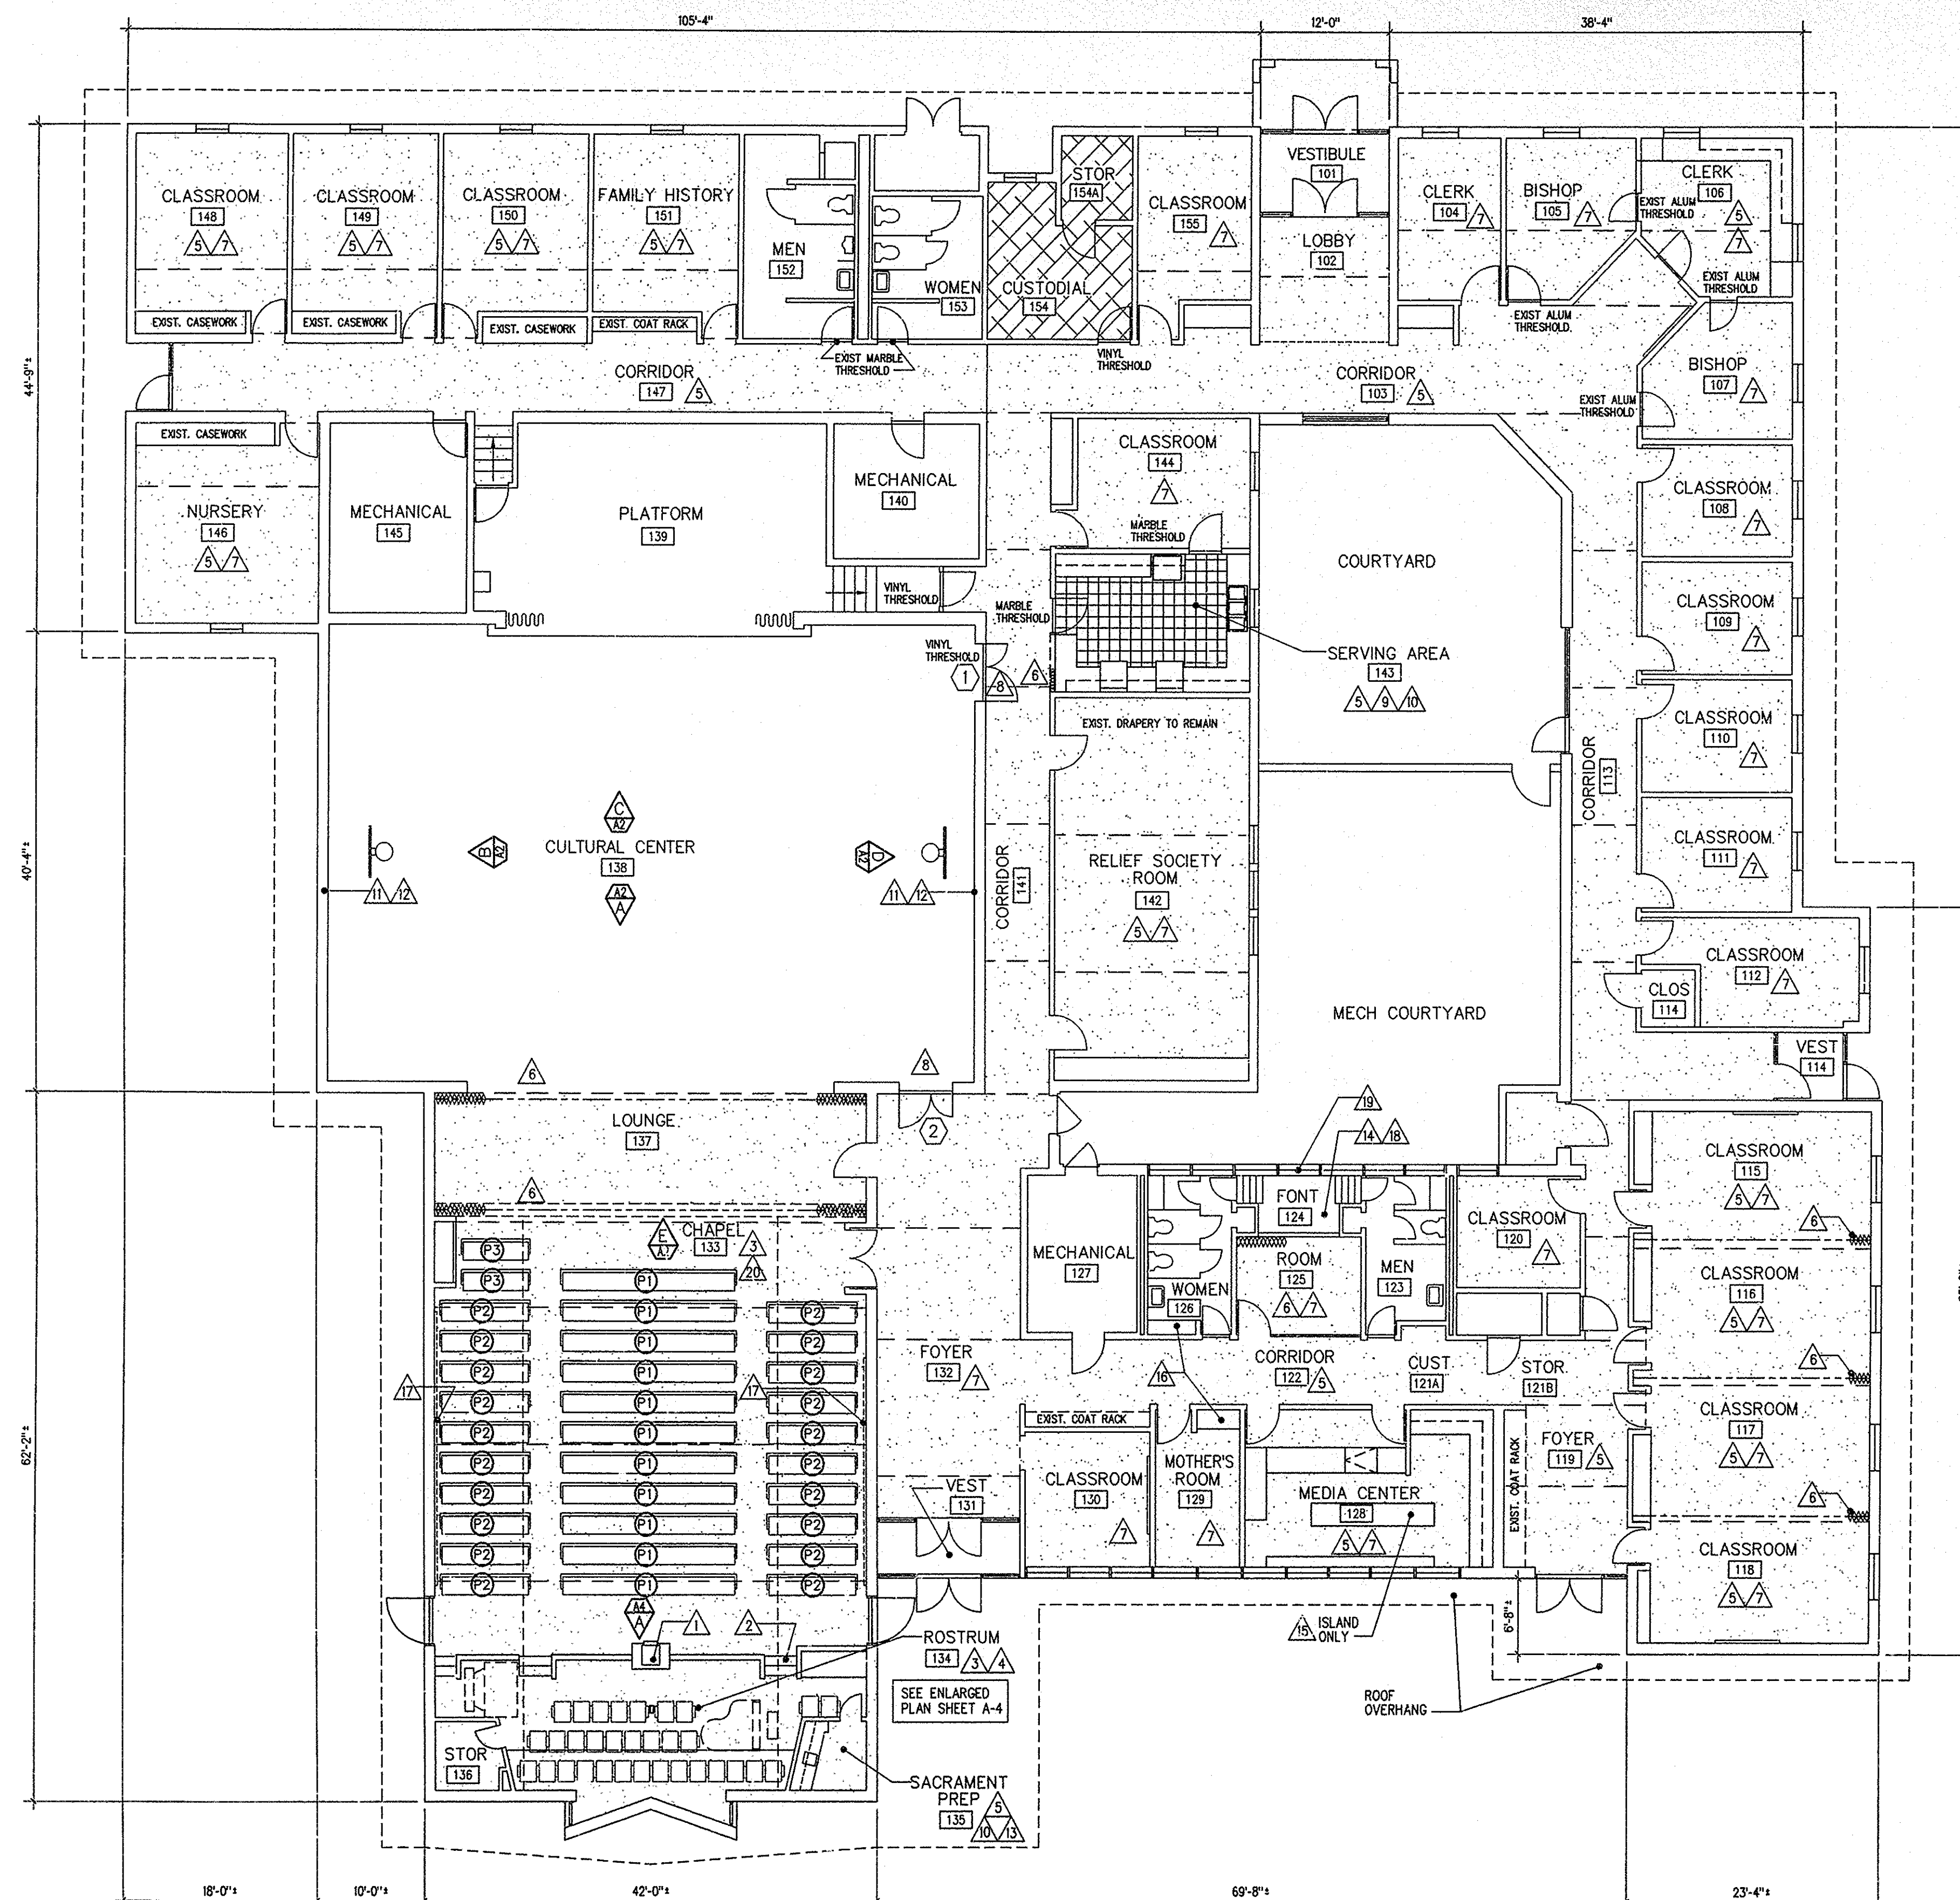

FLOOR PLAN
SCALE: 1/8" = 1'-0"

GENERAL NOTES:

- SEE FINISH SCHEDULE, DOOR SCHEDULE A-2, AND REFLECTED CEILING PLAN A-5 FOR WORK NOT SHOWN ON FLOOR PLAN.
- PATCH AND REPAIR SURFACES DAMAGED DURING CONSTRUCTION FLUSH WITH ADJACENT SURFACES.
- EXISTING DIMENSIONS ARE APPROXIMATE. VERIFY EXISTING DIMENSIONS AND CONDITIONS AFFECTING WORK. NOTIFY ARCHITECT OF DISCREPANCIES BETWEEN ACTUAL AND SHOWN CONDITIONS.
- PAINT ALL EXISTING INTERIOR & EXTERIOR HOLLOW METAL DOORS AND FRAMES.

NEW WORK NOTES:

- PROVIDE LECTERN AND LIFT MECHANISM.
 - PROVIDE ROSTRUM RAIL MODIFICATIONS AS DETAILED.
 - RENOVATE & REINSTALL EXISTING PEWS & ROSTRUM SEATING. SEE SPEC DIV. 12.
 - PROVIDE 5 NEW ROSTRUM SEATS TO MATCH RENOVATED SEATS. PROVIDE 6 NEW ENDS.
 - EXISTING CASEWORK TO REMAIN.
 - EXISTING FOLDING PARTITION TO REMAIN.
 - EXISTING CHAIR RAIL TO REMAIN.
 - NEW WOOD DOOR IN EXISTING HOLLOW METAL FRAME.
 - PROVIDE 3 COMPARTMENT SINK, FAUCETS & PLUMBING FITTINGS. TIE INTO EXISTING WATER & WASTE LINES. SEE P-1.
 - PROVIDE PLASTIC LAMINATE COUNTERTOP, (BACK & SIDE SPLASHES WHERE REQUIRED) ON EXISTING CASEWORK TO REMAIN. SEE ENLARGED PLAN, SHEET A-3.
 - PROVIDE ACOUSTICAL WALL PANELS, SEE ELEVATIONS SHT A-2.
 - PROVIDE SAFETY WAINSCOTING, SEE ELEVATIONS SHT A-2.
 - PROVIDE SINGLE COMPARTMENT SINK, FAUCET, & PLUMBING FITTINGS. TIE INTO EXISTING WATER & WASTE LINES. SEE P-1.
 - PROVIDE FONT MIRROR. SEE ENLARGED PLAN, SHT A-3.
 - PROVIDE A PLASTIC LAMINATE COUNTERTOP ON EXISTING OPEN BASE CABINET, APPROX. SIZE 12'-6" x 2'-0". SEE SECTION 6/A-3.
 - PROVIDE PLASTIC LAMINATE COUNTERTOP BACK & SIDE SPLASHES ON EXISTING METAL BRACKETS, SEE DETAIL 7/A-3.
 - AFTER WALL PAINTING IS COMPLETE, REINSTALL EXISTING ACOUSTICAL WALL PANELS ON EXISTING SUPPORT HARDWARE IN ORIGINAL LOCATIONS.
 - PROVIDE 2 SURFACE MOUNTED CEILING LIGHT FIXTURES, COLUMBIA MODEL # WC4-232-EBB-120, OR APPROVED EQUAL.
 - MODIFY 3 EXISTING FIXED WINDOWS IN FONT AS INDICATED ON DETAIL 5/A3.
 - PROVIDE CHAPEL LIGHT CONTROL FOR THE FIXTURES FEED FROM CIRCUITS 1,3 & 13 IN PANEL LOCATED IN CORRIDOR 122.
- PROVIDE LIGHTING CONTROL USING GE REMOTE CONTROL LOW VOLTAGE SWITCHING EQUIPMENT. THE EXISTING SWITCH LOCATION (CURRENTLY FOR CENTER 3 CHAPEL FIXTURES) SHALL BE REUSED.
- PROVIDE A GENERAL ELECTRIC (GE) LIGHT CONTROL RELAY PANEL W/ POWER SUPPLY & 3 CONTROL RELAYS, 3-SWITCH SINGLE GANG SWITCH PLATE & 3 CONTROL SWITCHES. LOCATE THE RELAY PANEL IN AN ACCESSIBLE LOCATION IN THE ATTIC ABOVE THE CHAPEL. REWORK THE 3 120VAC LIGHTING CIRCUITS THRU THE RELAY PANEL. PROVIDE LOW VOLTAGE CABLEING FROM THE RELAY PANEL TO THE CONTROL SWITCHES. THE CONTROL SWITCHES SHALL BE LOCATED AT THE EXIST CHAPEL SWITCH LOCATION. WIRING & CONNECTIONS SHALL BE MADE IN ACCORDANCE W/ THE MANUFACTURERS INSTRUCTIONS. LISTED BELOW ARE THE GE COMPONENTS REQUIRED:

QTY	ITEM
1	ENCLOSURE MODEL RBS 2
1	ENCLOSURE MODEL RBS 2
3	RELAY MODEL RR7P
1	SINGLE GANG 3-SWITCHPLATE MODEL RP 3
3	LOW VOLTAGE SWITCHES MODEL RFS 6

FLOORING LEGEND

	SEAM		CARPET		PAVER TILE
	SHEET VINYL		EXISTING TO REMAIN		

NOTE: CARPET SEAMS BELOW DOORS NOT SHOWN FOR CLARITY.

PEW SCHEDULE

MARK	NO.	REQ.	LENGTH	REMARKS
(P1)	11		18'-0"	REINSTALL PEWS TO THEIR ORIGINAL LOCATION
(P2)	20		8'-0"	INSTALL PEWS ON OPP SIDE OF CHAPEL FROM ORIGINAL LOCATION
(P3)	2		6'-0"	REINSTALL PEWS TO THEIR ORIGINAL LOCATION
NOTE: SPACE ALL PEWS 2'-8" BACK TO BACK				

NOTE

SEE DIVISION 01 SPECIAL REQUIREMENTS OF SPECIFICATION FOR INSTRUCTIONS CONCERNING THE FOLLOWING:

FURNISHED BY	ITEM	BRAND	STYLE OR TYPE	COLOR
CONTRACTOR	CARPET	SEE SPEC DIV. 09	LOOP PILE	ATLANTIS
CONTRACTOR	COUNTERTOPS	SEE SPEC DIV. 06		AS SELECTED
CONTRACTOR	PEWS & ROSTRUM SEATING RENOVATION	SEE SPEC DIV. 12		
CONTRACTOR	ROSTRUM SEATING	SEE SPEC DIV. 12		
CONTRACTOR	ROSTRUM CASEWORK	SEE SPEC DIV. 6	SEE SHEETS A-4 & A-5	

DATE
10 SEPT 1999

REVISIONS

THOMPSON AND WRIGHT, ARCHITECTS, LTD.

505-C CEDAR ROAD
CHESAPEAKE, VIRGINIA 23322
757-436-0861

UPGRADES TO
DEEP CREEK, PORTSMOUTH WARDS

CHESAPEAKE VIRGINIA STAKE
CHEROKEE ROAD
PORTSMOUTH, VIRGINIA 23701

SHEET TITLE
FLOOR PLAN

DRAWN BY: HTK
CHECKED BY: WAT

PROPERTY NUMBER
500-6627

DEVELOPMENT NUMBER

SHEET NO.

A-1

ROLL # ITEM FRAME
826 173 1774

24X