
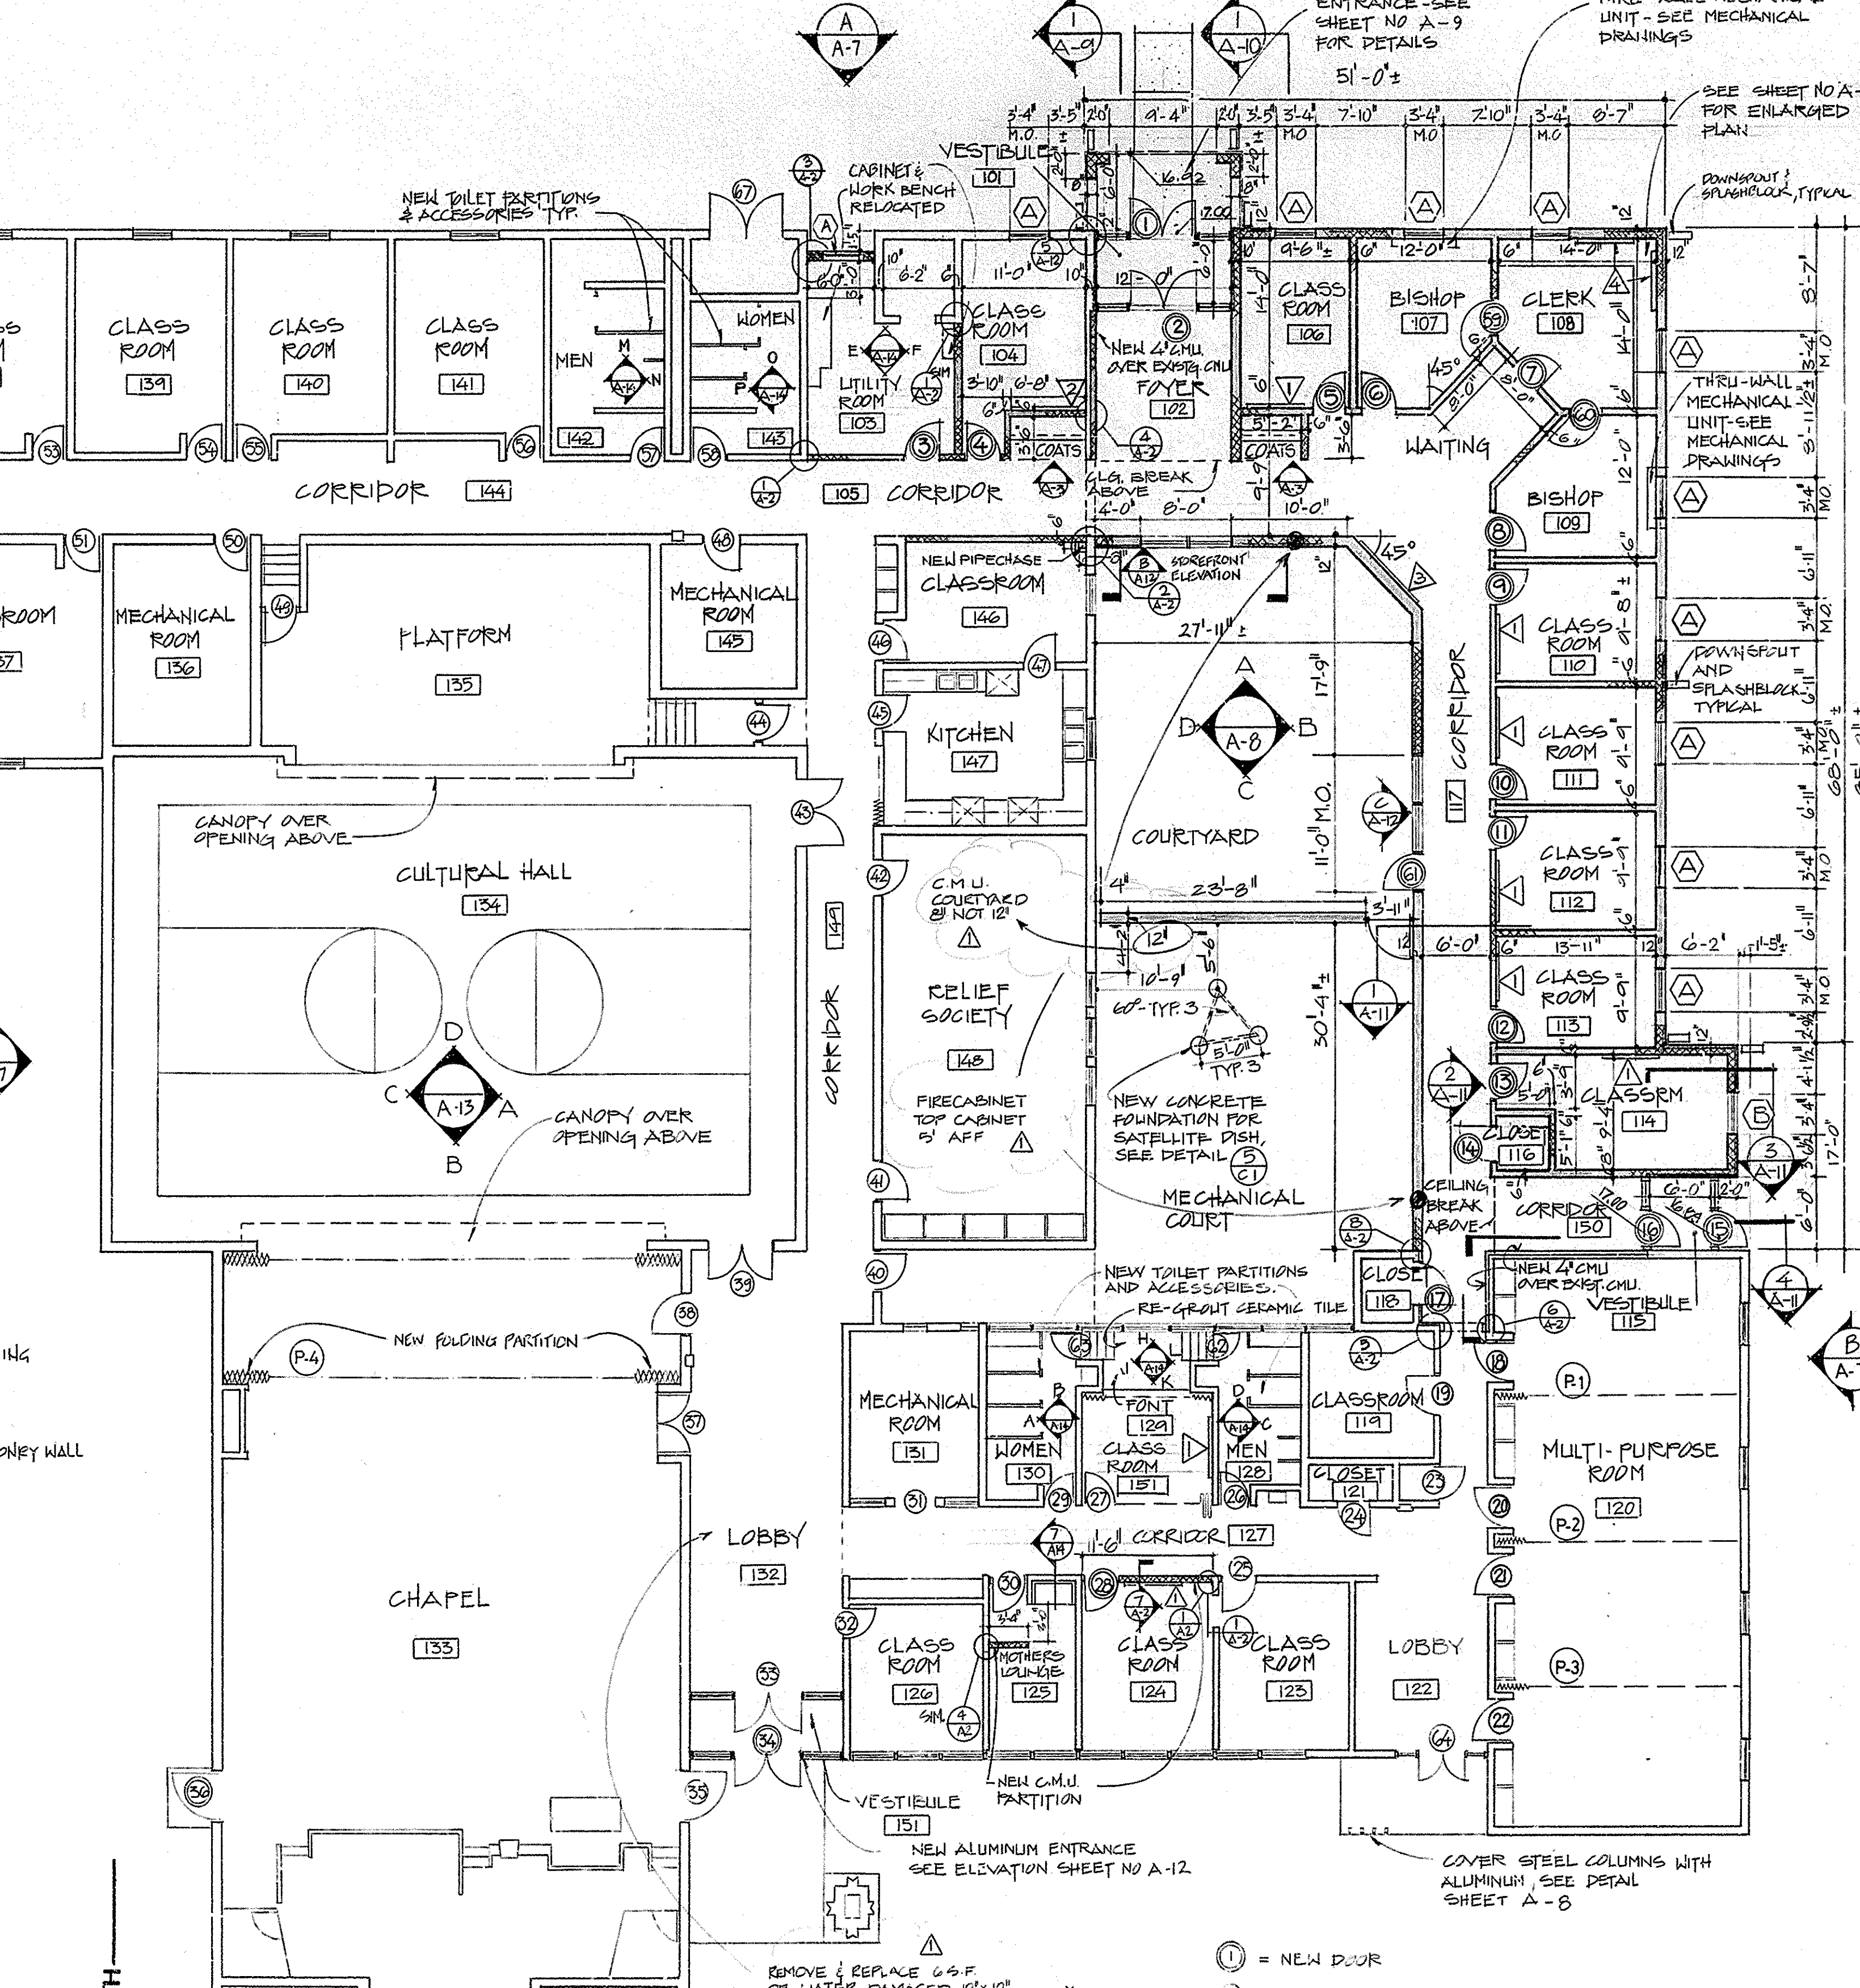


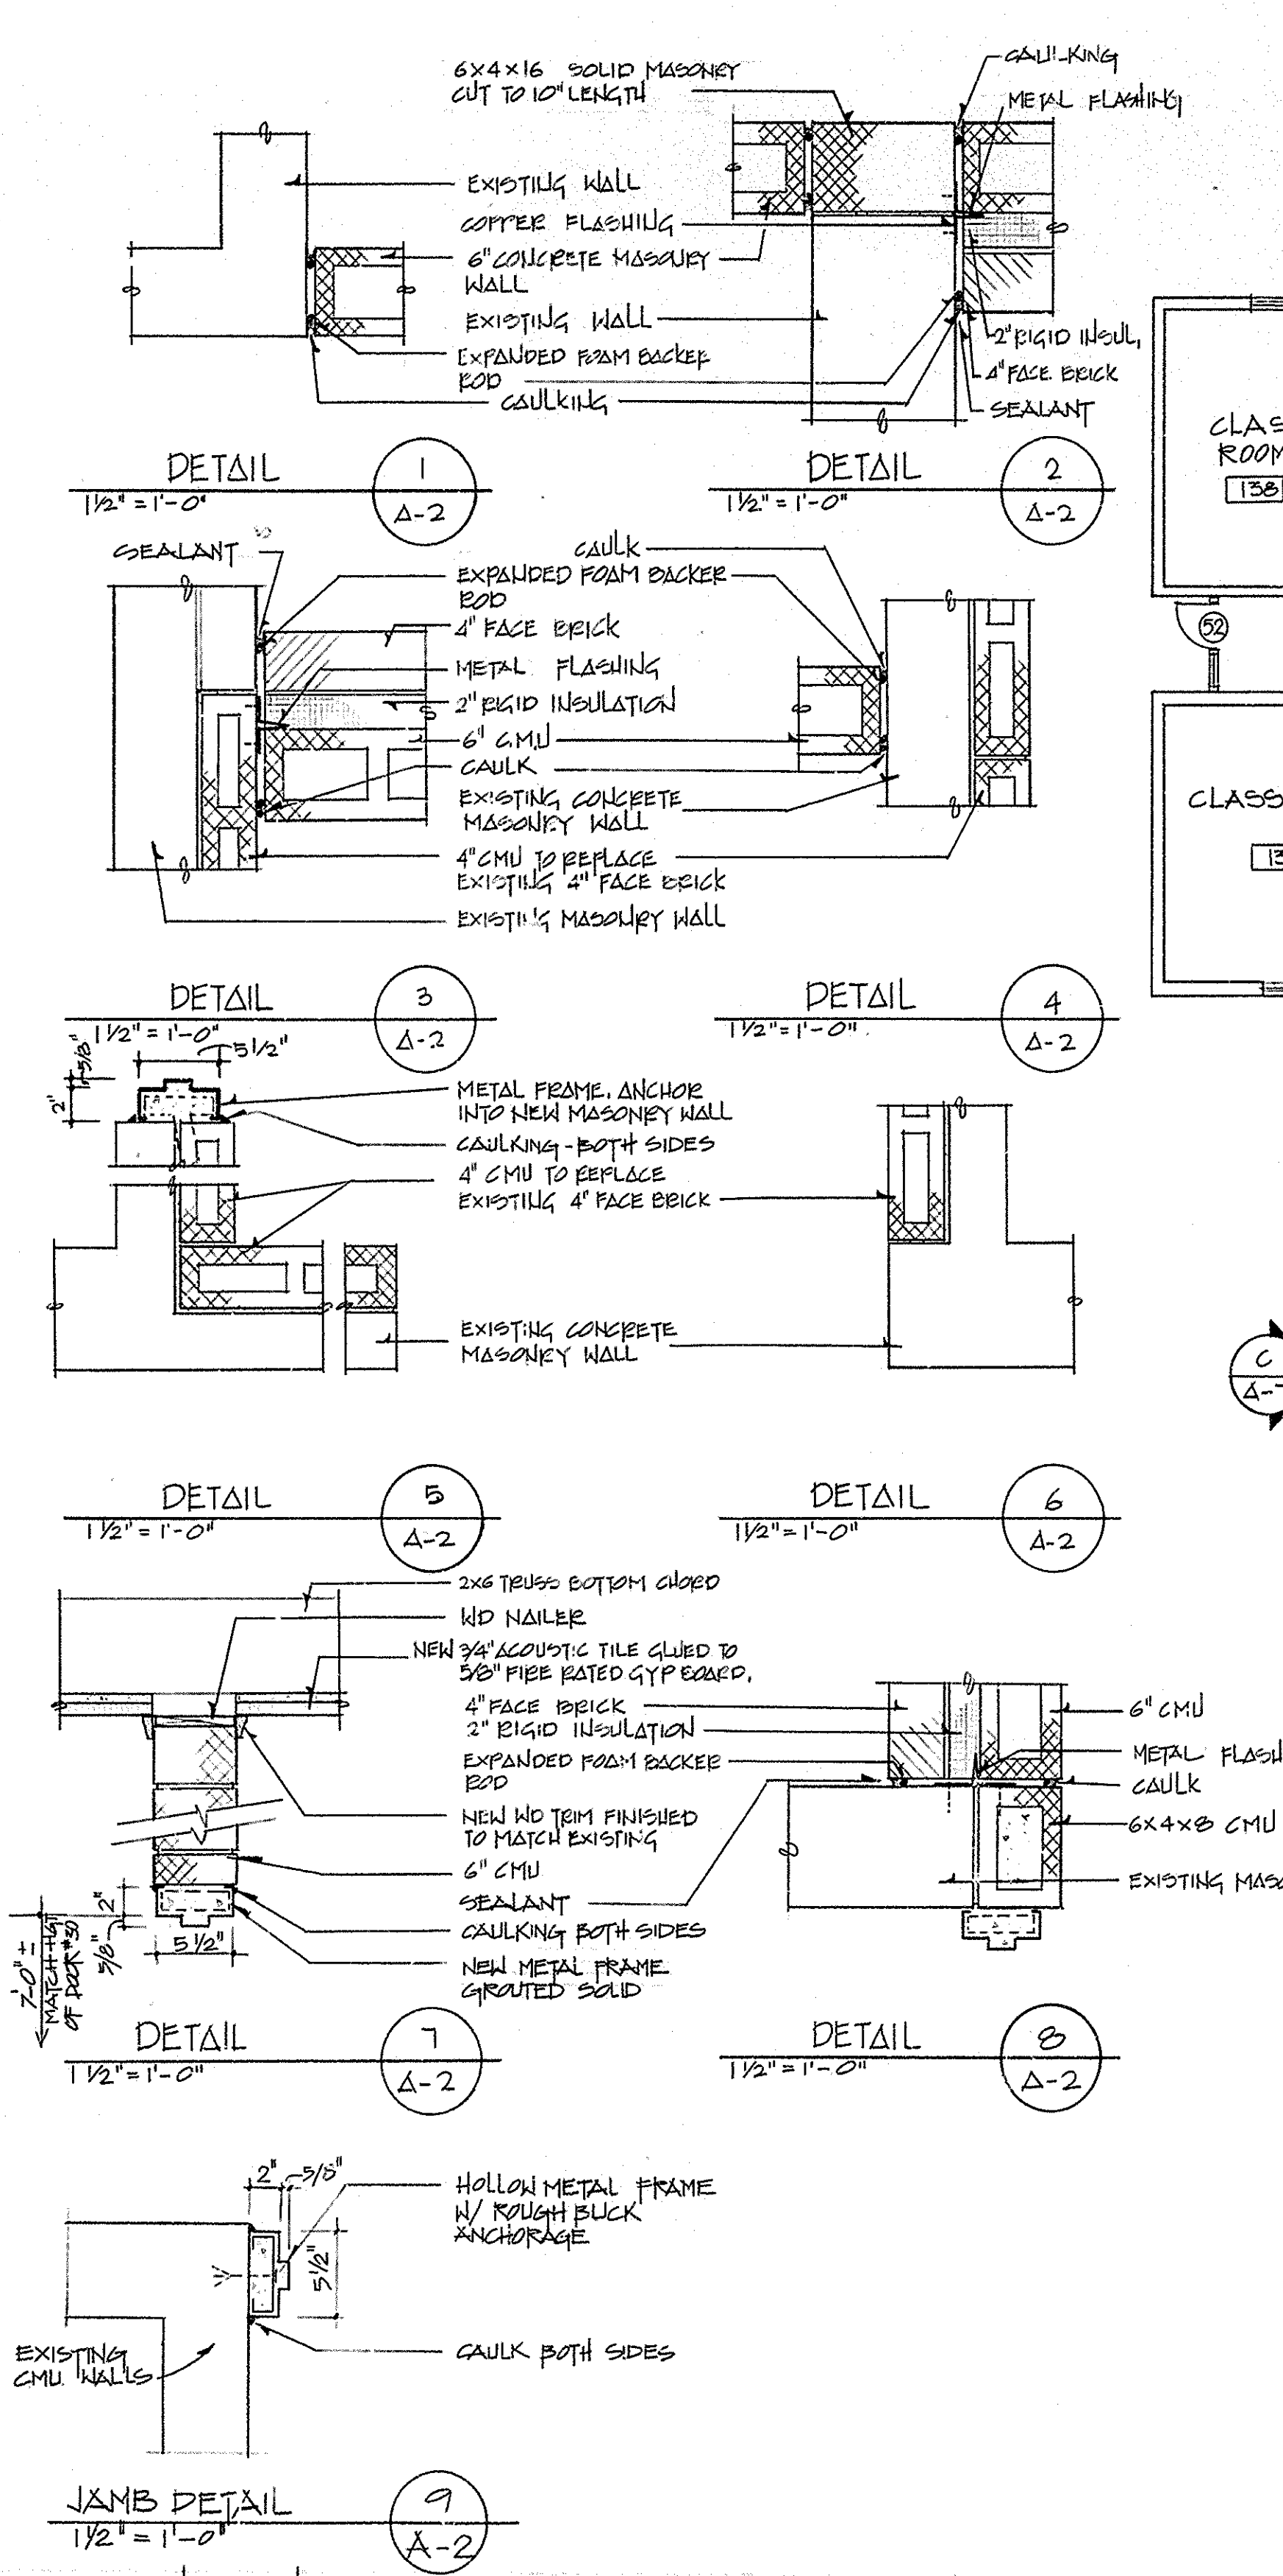

DILLS, AINSWORTH & ASSOCIATES
 ARCHITECTS
 1432 N. Great Neck Road, Suite 103, Virginia Beach, Va. 23464 • (804) 481-4357

**PORTSMOUTH WARD
 ADDITION / REMODELING**
 NEWPORT NEWS, VIRGINIA STATE
 PORTSMOUTH, VIRGINIA

THE CHURCH OF JESUS CHRIST OF LATTER-DAY SAINTS

Revisions
 A6-BUILTS 10-7-85

Designed DCD
 Drawn AB
 Checked DCD
 Scale 1/8" = 1'-0"
 Date 19 AUG 83
 Project No. 500-6627-75
 Sheet No. 7

A-2
 of 32 Sheets